


Second Floor General Arrangement
 AS BUILT
 SCALE: 1:20

GENERAL NOTES

DO NOT SCALE FROM DRAWING.
 ALL MARKED DIMENSIONS TO BE
 CHECKED ON SITE BY CONTRACTOR
 PRIOR TO CONSTRUCTION.

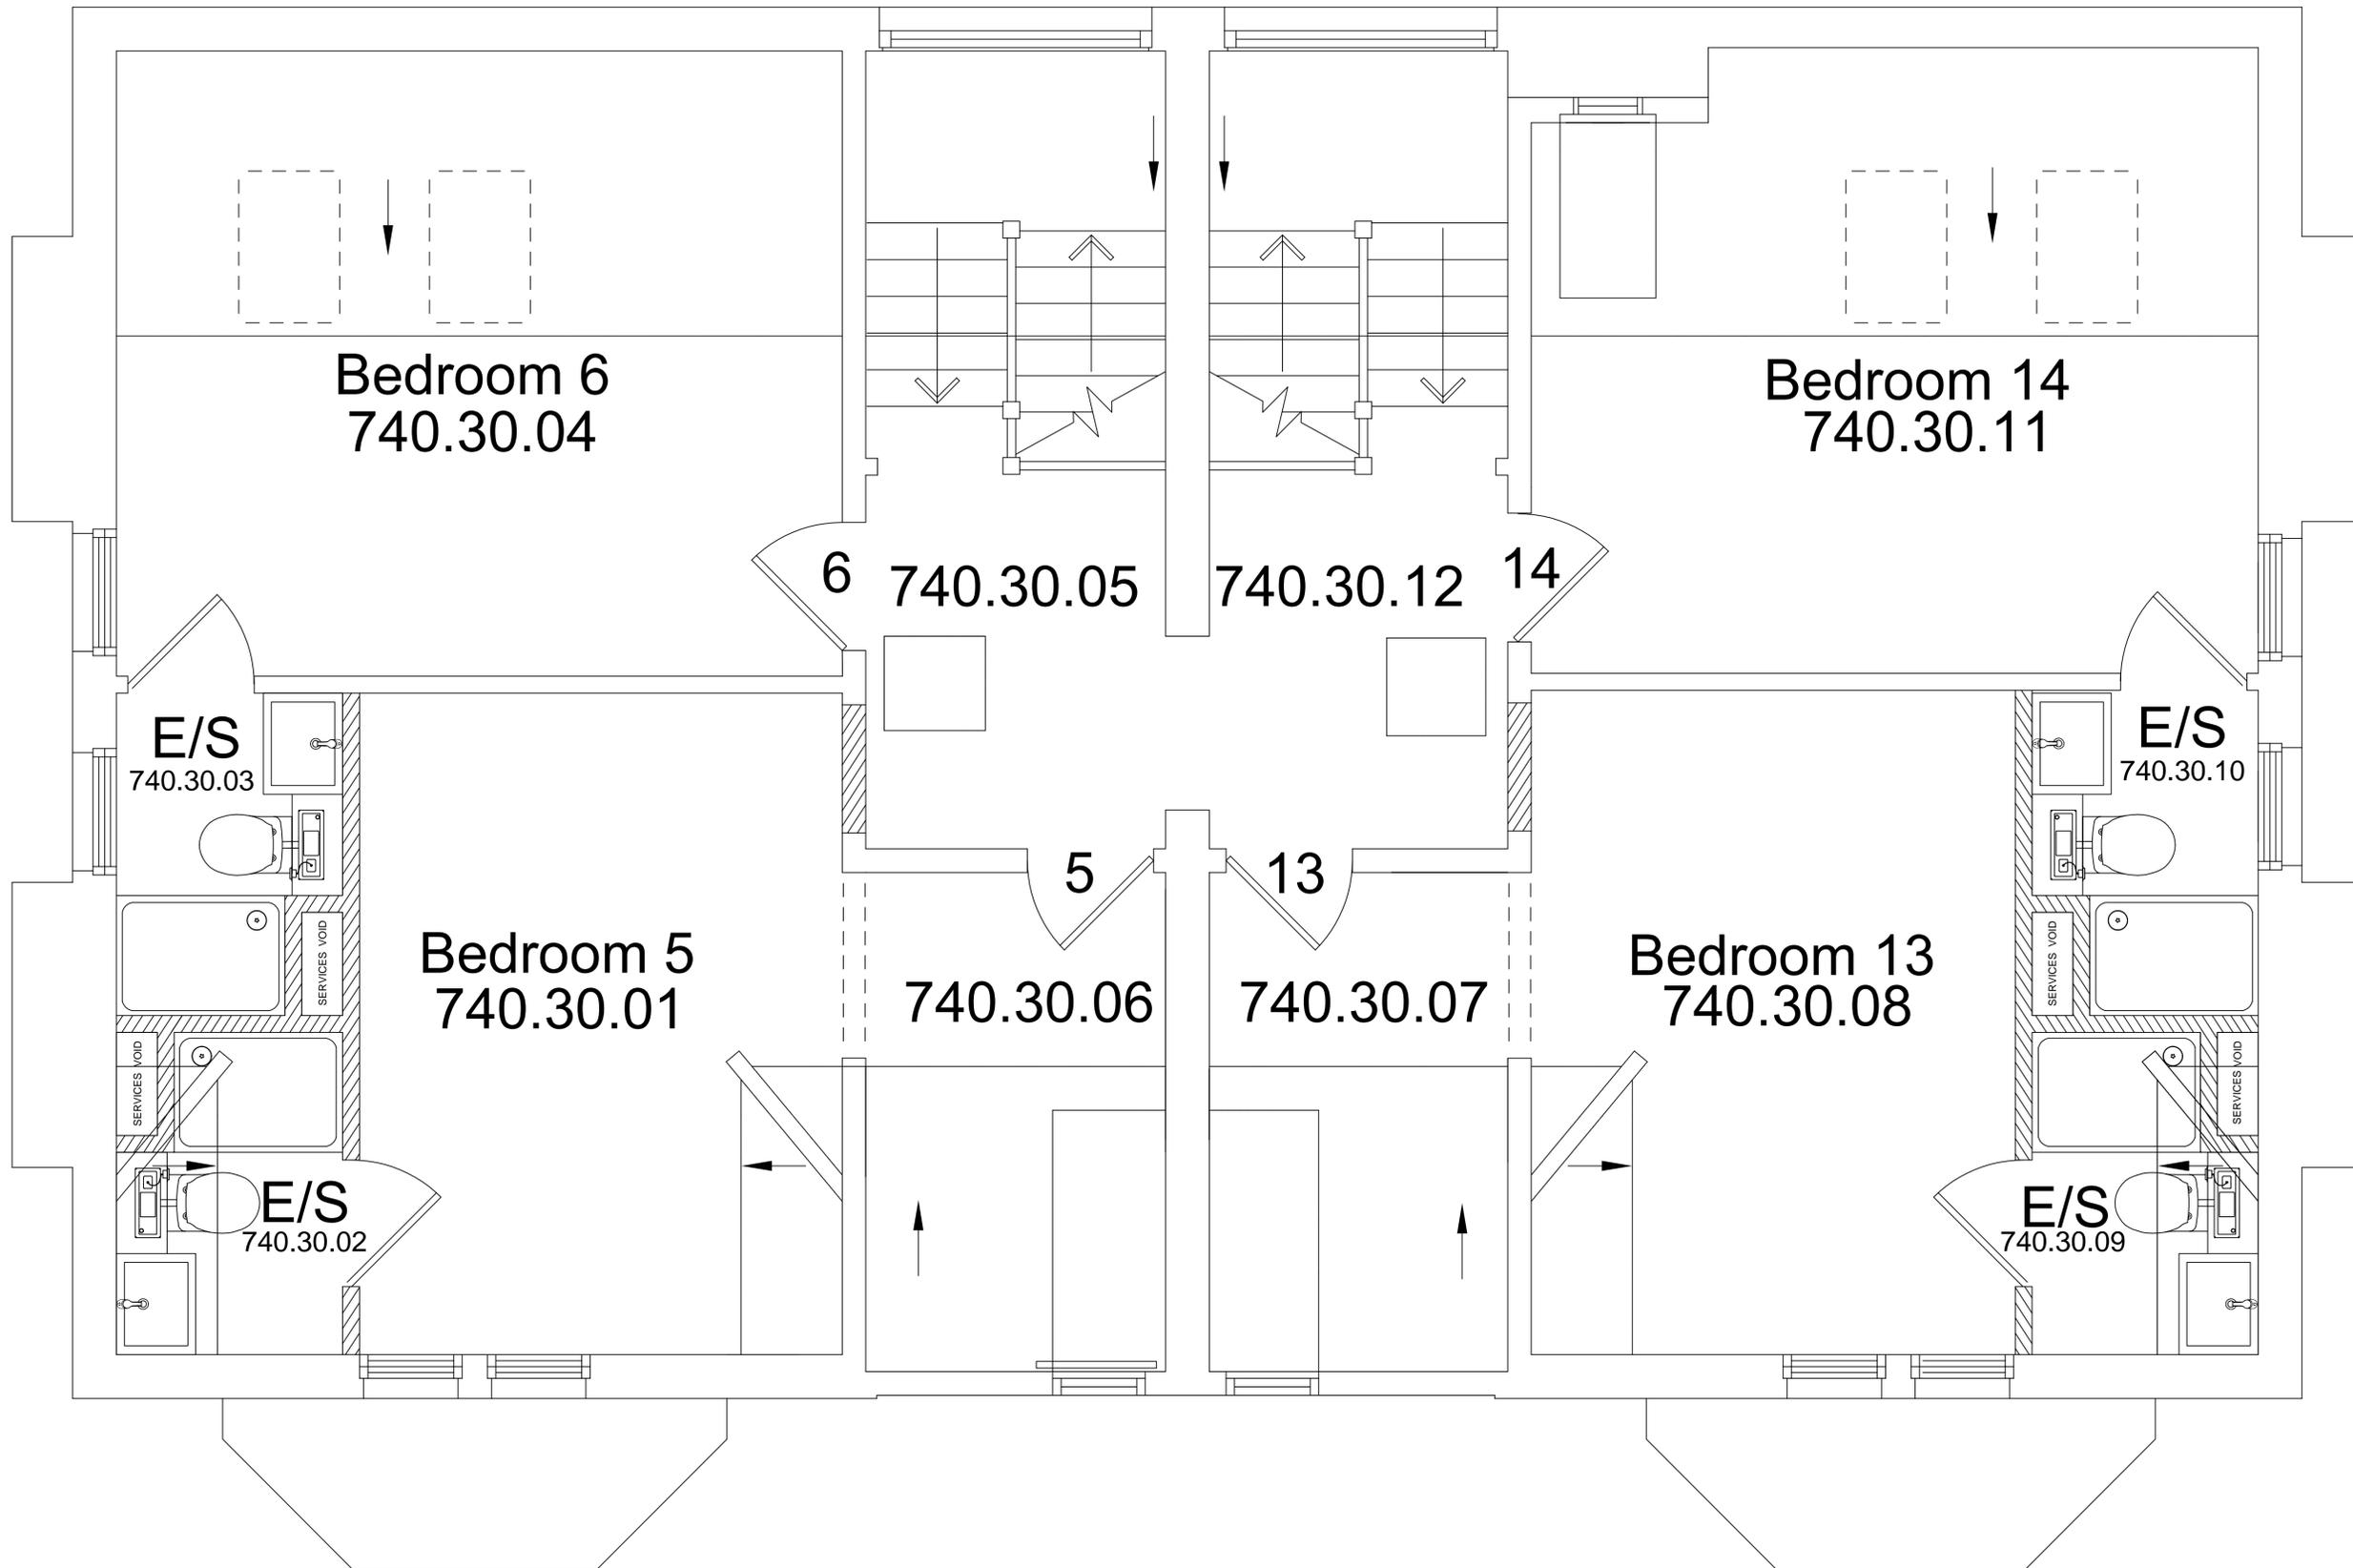

AS BUILT



ESTATES SERVICES			
PROJECT	Refurbishment & Internal Alteration Works Project		
DRAWING	Second Floor As Built Layout		
BUILDING	38-40 Woodstock Road (Graduate Accommodation)		
FLOOR	Second		
DRAWING NO	740/A04		
SCALE	1:20	SIZE	A1
DRAWN BY	MW	REVISION	
CHECKED BY		DATE	26 Aug 2015
CHECK ALL DIMENSIONS. DO NOT SCALE			
© OXFORD UNIVERSITY ESTATES SERVICES			