


Lower Ground Floor General Arrangement  
 AS BUILT  
 SCALE: 1:25

GENERAL NOTES  
 DO NOT SCALE FROM DRAWING.  
 ALL MARKED DIMENSIONS TO BE  
 CHECKED ON SITE BY CONTRACTOR  
 PRIOR TO CONSTRUCTION.



**AS BUILT**

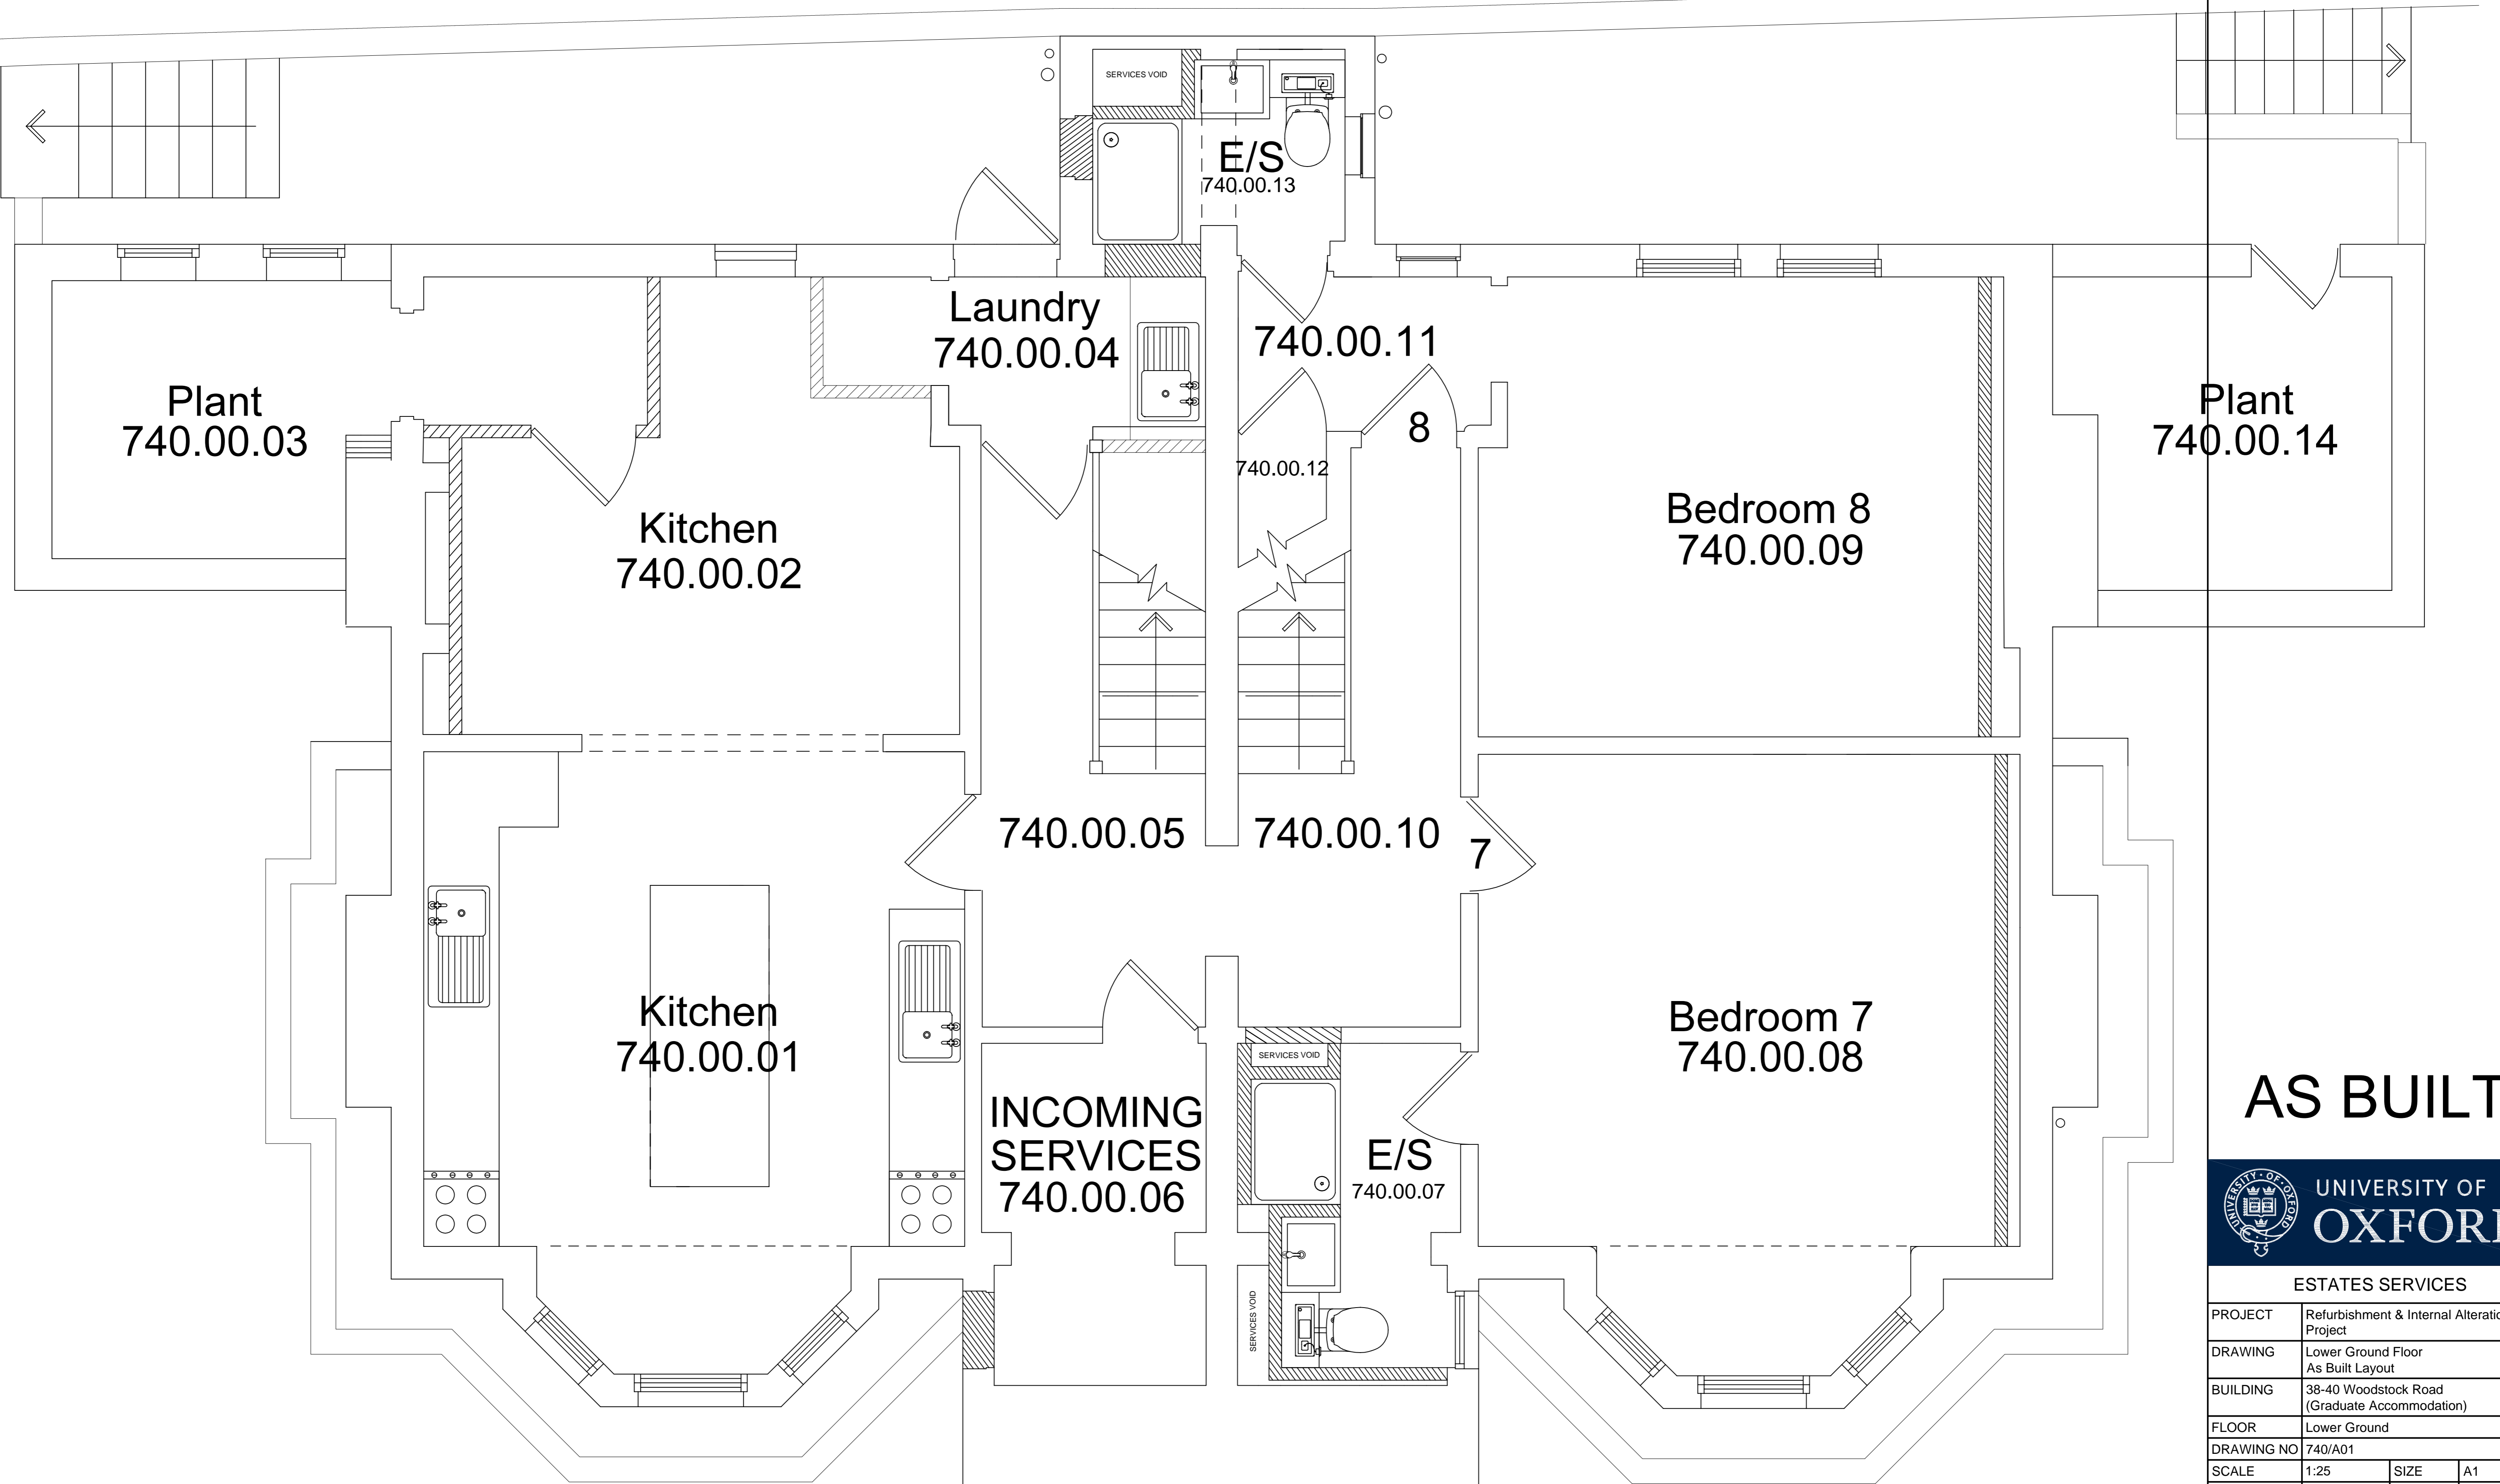

ESTATES SERVICES			
PROJECT	Refurbishment & Internal Alteration Works Project		
DRAWING	Lower Ground Floor As Built Layout		
BUILDING	38-40 Woodstock Road (Graduate Accommodation)		
FLOOR	Lower Ground		
DRAWING NO	740/A01		
SCALE	1:25	SIZE	A1
DRAWN BY	MW	REVISION	
CHECKED BY		DATE	26 Aug 2015
CHECK ALL DIMENSIONS. DO NOT SCALE			
© OXFORD UNIVERSITY ESTATES SERVICES			